

GENERAL NOTES:

1. DRAWINGS TO BE READ IN CONJUNCTION WITH STRUCTURAL ENGINEERS DRAWINGS, M+E DRAWINGS, SPECIFICATIONS AND ARCHITECTS DRAWINGS.
2. ALL CONSTRUCTION METHODS TO COMPLY WITH HEALTH AND SAFETY REGULATIONS AND ALL OTHER STATUTORY REGULATIONS.
3. ALL WORKS TO COMPLY WITH RELEVANT BRITISH STANDARDS (BS) AND EUROPEAN STANDARDS WHERE APPLICABLE.
4. SHOP DRAWINGS MUST BE REQUIRED, TO BE INSPECTED BY ARCHITECT AND ENGINEERS.

VELFAC SYSTEM 200 LOW-E DOUBLE GLAZED UNIT. OUTER FRAME PFC COLOUR: RAL 7010

2 - No.10 (MIN) STAGGERED FIXING SCREWS

10g GALV. STEEL FIXING STRAP

PRECOMPRESSED EXPANDING POLYURETHANE (SIZED TO SUIT TOLERANCE) COLOUR: BLACK

2 LAYERS "AUREFLEX 212" DOUBLE FOIL FRAGED INSULATION MEMBRANE BY THERMAL ECONOMICS LTD.

CUT CURS B ENGINEERING BRICK (SECONDS)

"HULLORD ORIGINAL" SHEET DPC OR SIMILAR APPROVED SPOT BONDED TO P.C. CONCRETE CILL AND FULLY BENDED IN METERS. END DETAILS (UNION WITH VERTICAL INSULATION/DPC TO BE DEVELOPED WITH ACID ETCHED FINISH TO BS 5642 WITH FACES

FACING BRICK

"HULLORD ORIGINAL" DPC

60 x 80 x 6mm RSA

"EXPANDAFORM" BACKING TO SEALANT BY FOSROC LTD.

"AUREFLEX 212" DOUBLE FOIL FRAGED INSULATION MEMBRANE BY THERMAL ECONOMICS LTD.

BUILT IN RECESSED GMS

METER BOX. GAS BOX:

EXTERNAL SIZE: 600mm HIGH X 410mm WIDE

SIZE OF HOLE IN OUTER LEAF TO ACCOMMODATE METER BOX:

552mm HIGH X 366mm WIDE

"THIOFLEX 600" TWO PART POLYSULPHIDE JOINT SEALANT BY FOSROC LTD TO ALL SIDES OF METER BOX. COLOUR: GREY

"PLASPRUFE 2000 SA" BY RIVERROD TAKEN BEHIND METER BOX & UP TO CILL DPC AS INDICATED. PLASPRUFE TO PROTECT 200mm EITHER SIDE OF METER BOX.

103mm CURS B ENGINEERING BRICKS (SECONDS)


"AUREFLEX 212" INSULATION TAKEN BEHIND METER BOX.

"BLUE SOVEREIGN STOCK" BRICKS BELOW DPC LEVEL TO 3 COURSES BELOW GROUND LEVEL.

"HULLORD ORIGINAL" SHEET DPC OR SIMILAR APPROVED BELOW METER BOX AND TAKEN UP SIDES TO BE SEALED & LAPPED WITH G.L. PERIMETER CAVITY TRAY.

"EXPANDAFORM" BACKING TO SEALANT BY FOSROC LTD.

"THIOFLEX 600" TWO PART POLYSULPHIDE JOINT SEALANT BY FOSROC LTD TO ALL SIDES OF METER BOX. COLOUR: GREY

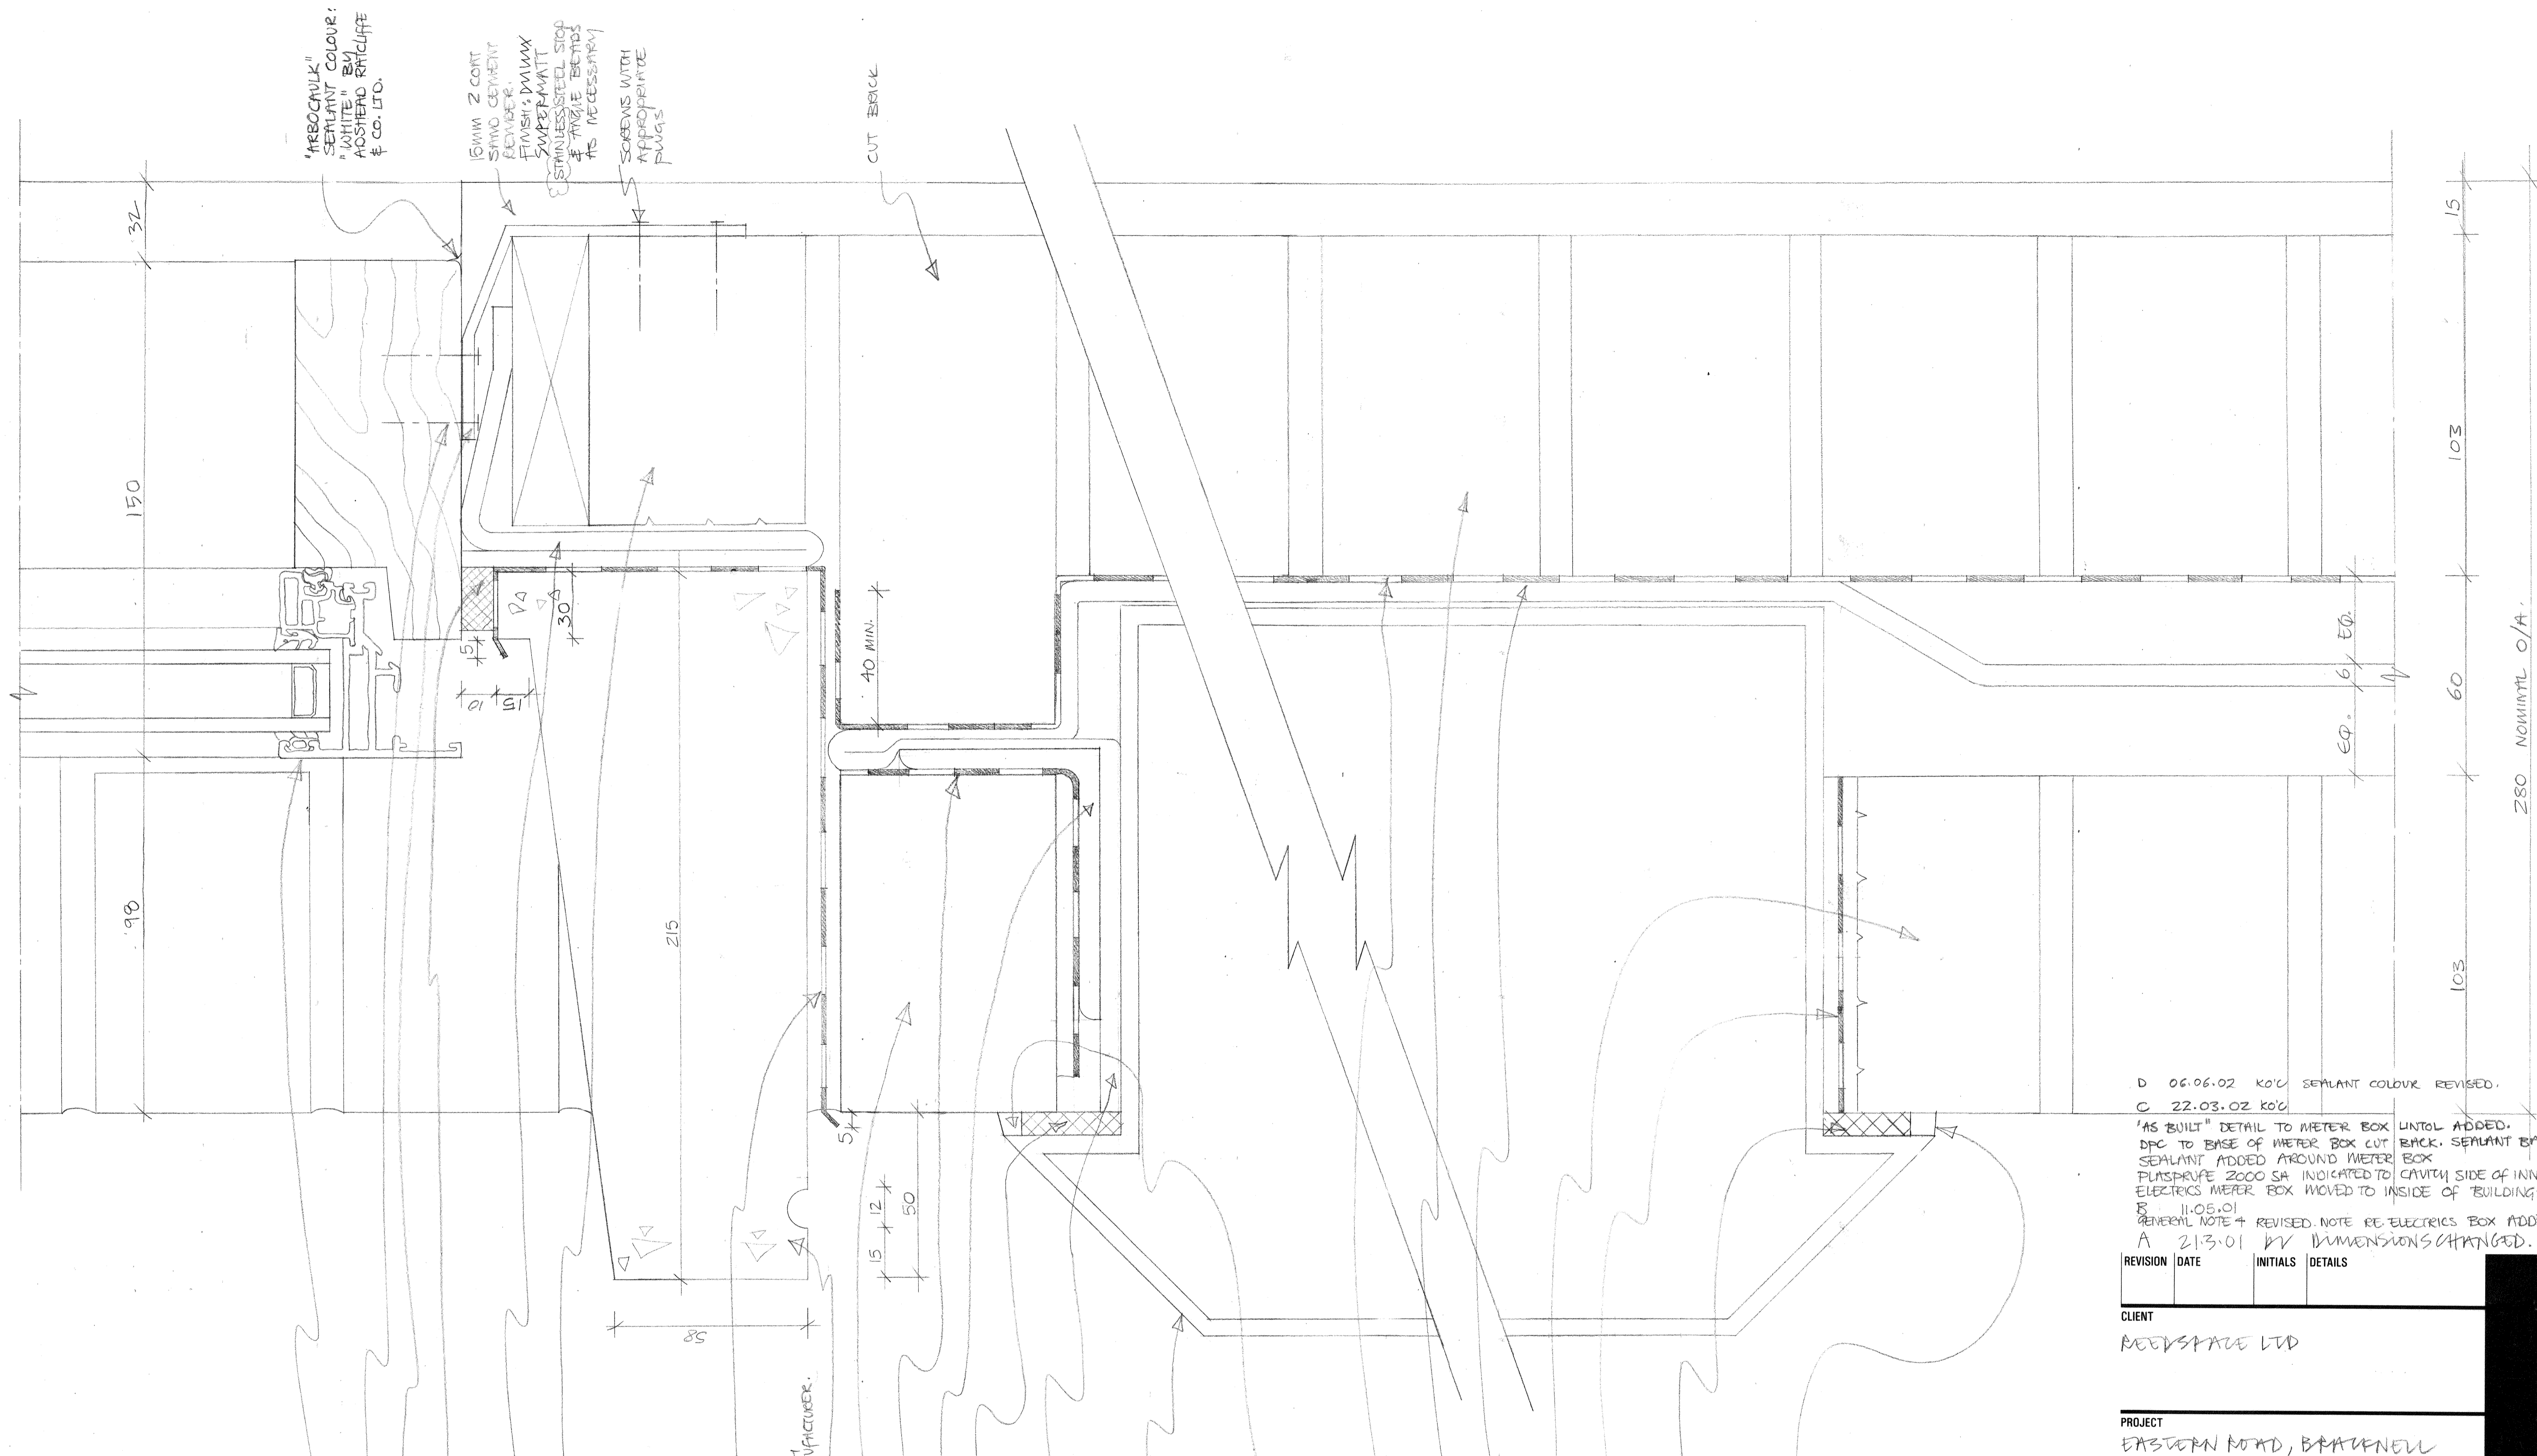

D 06.06.02 KOL SEALANT COLOUR REVISED.  
 C 22.03.02 KOL  
 "AS BUILT" DETAIL TO METER BOX UNTIL ADDED.  
 DPC TO BASE OF METER BOX CUT BACK. SEALANT BACKING REVISED  
 SEALANT ADDED AROUND METER BOX  
 PLASPRUFE 2000 SA INDICATED TO CAVITY SIDE OF INNER LEAF.  
 ELECTRICS METER BOX MOVED TO INSIDE OF BUILDINGS.  
 B 11.05.01  
 GENERAL NOTE 4 REVISED. NOTE RE ELECTRICS BOX ADDED.  
 A 21.3.01 BY DIMENSIONS CHANGED.

REVISION	DATE	INITIALS	DETAILS

CLIENT  
 REEDSPACE LTD

PROJECT  
 EASTERN ROAD, BRAUNELL

DRAWING  
 VERTICAL SECTION THROUGH  
 CILL AND METER BOX  
 (TYPICAL)

SCALE  
 FMM SIZE

DRAWING NO.  
 9901/42 D

DATE  
 MAR 00

DRAWN BY  
 KOL

Do not scale drawing. Dimensions to be verified on site.  
 This drawing is the property of Bill Reed Architecture and they reserve the copyright. The drawing is issued on the condition that it is not copied, reproduced, retained or disclosed to any unauthorised person, either wholly or in part, without the consent in writing of Bill Reed Architecture.

**BILL REED ARCHITECTURE**  
 44 KINGS TERRACE, LONDON NW1 OUR TELEPHONE 071-387 4521 FAX 071-387 2284

1 SECTION THROUGH GMS.  
 42 METER BOX + WINDOW CILL (TYPICAL) 1:1